


MILEAGE IN  
COUNTY HIGHWAY SYSTEM

TOWNSHIP	MILES
Adams	18.37
Chester	31.75
Clark	31.75
Green	28.25
Jefferson	18.80
Liberty	21.50
Marion	23.32
Richland	11.25
Union	27.00
Vernon	19.63
Washington	25.00
Wayne	25.80
Wilson	16.45
<b>TOTAL</b>	<b>298.87</b>

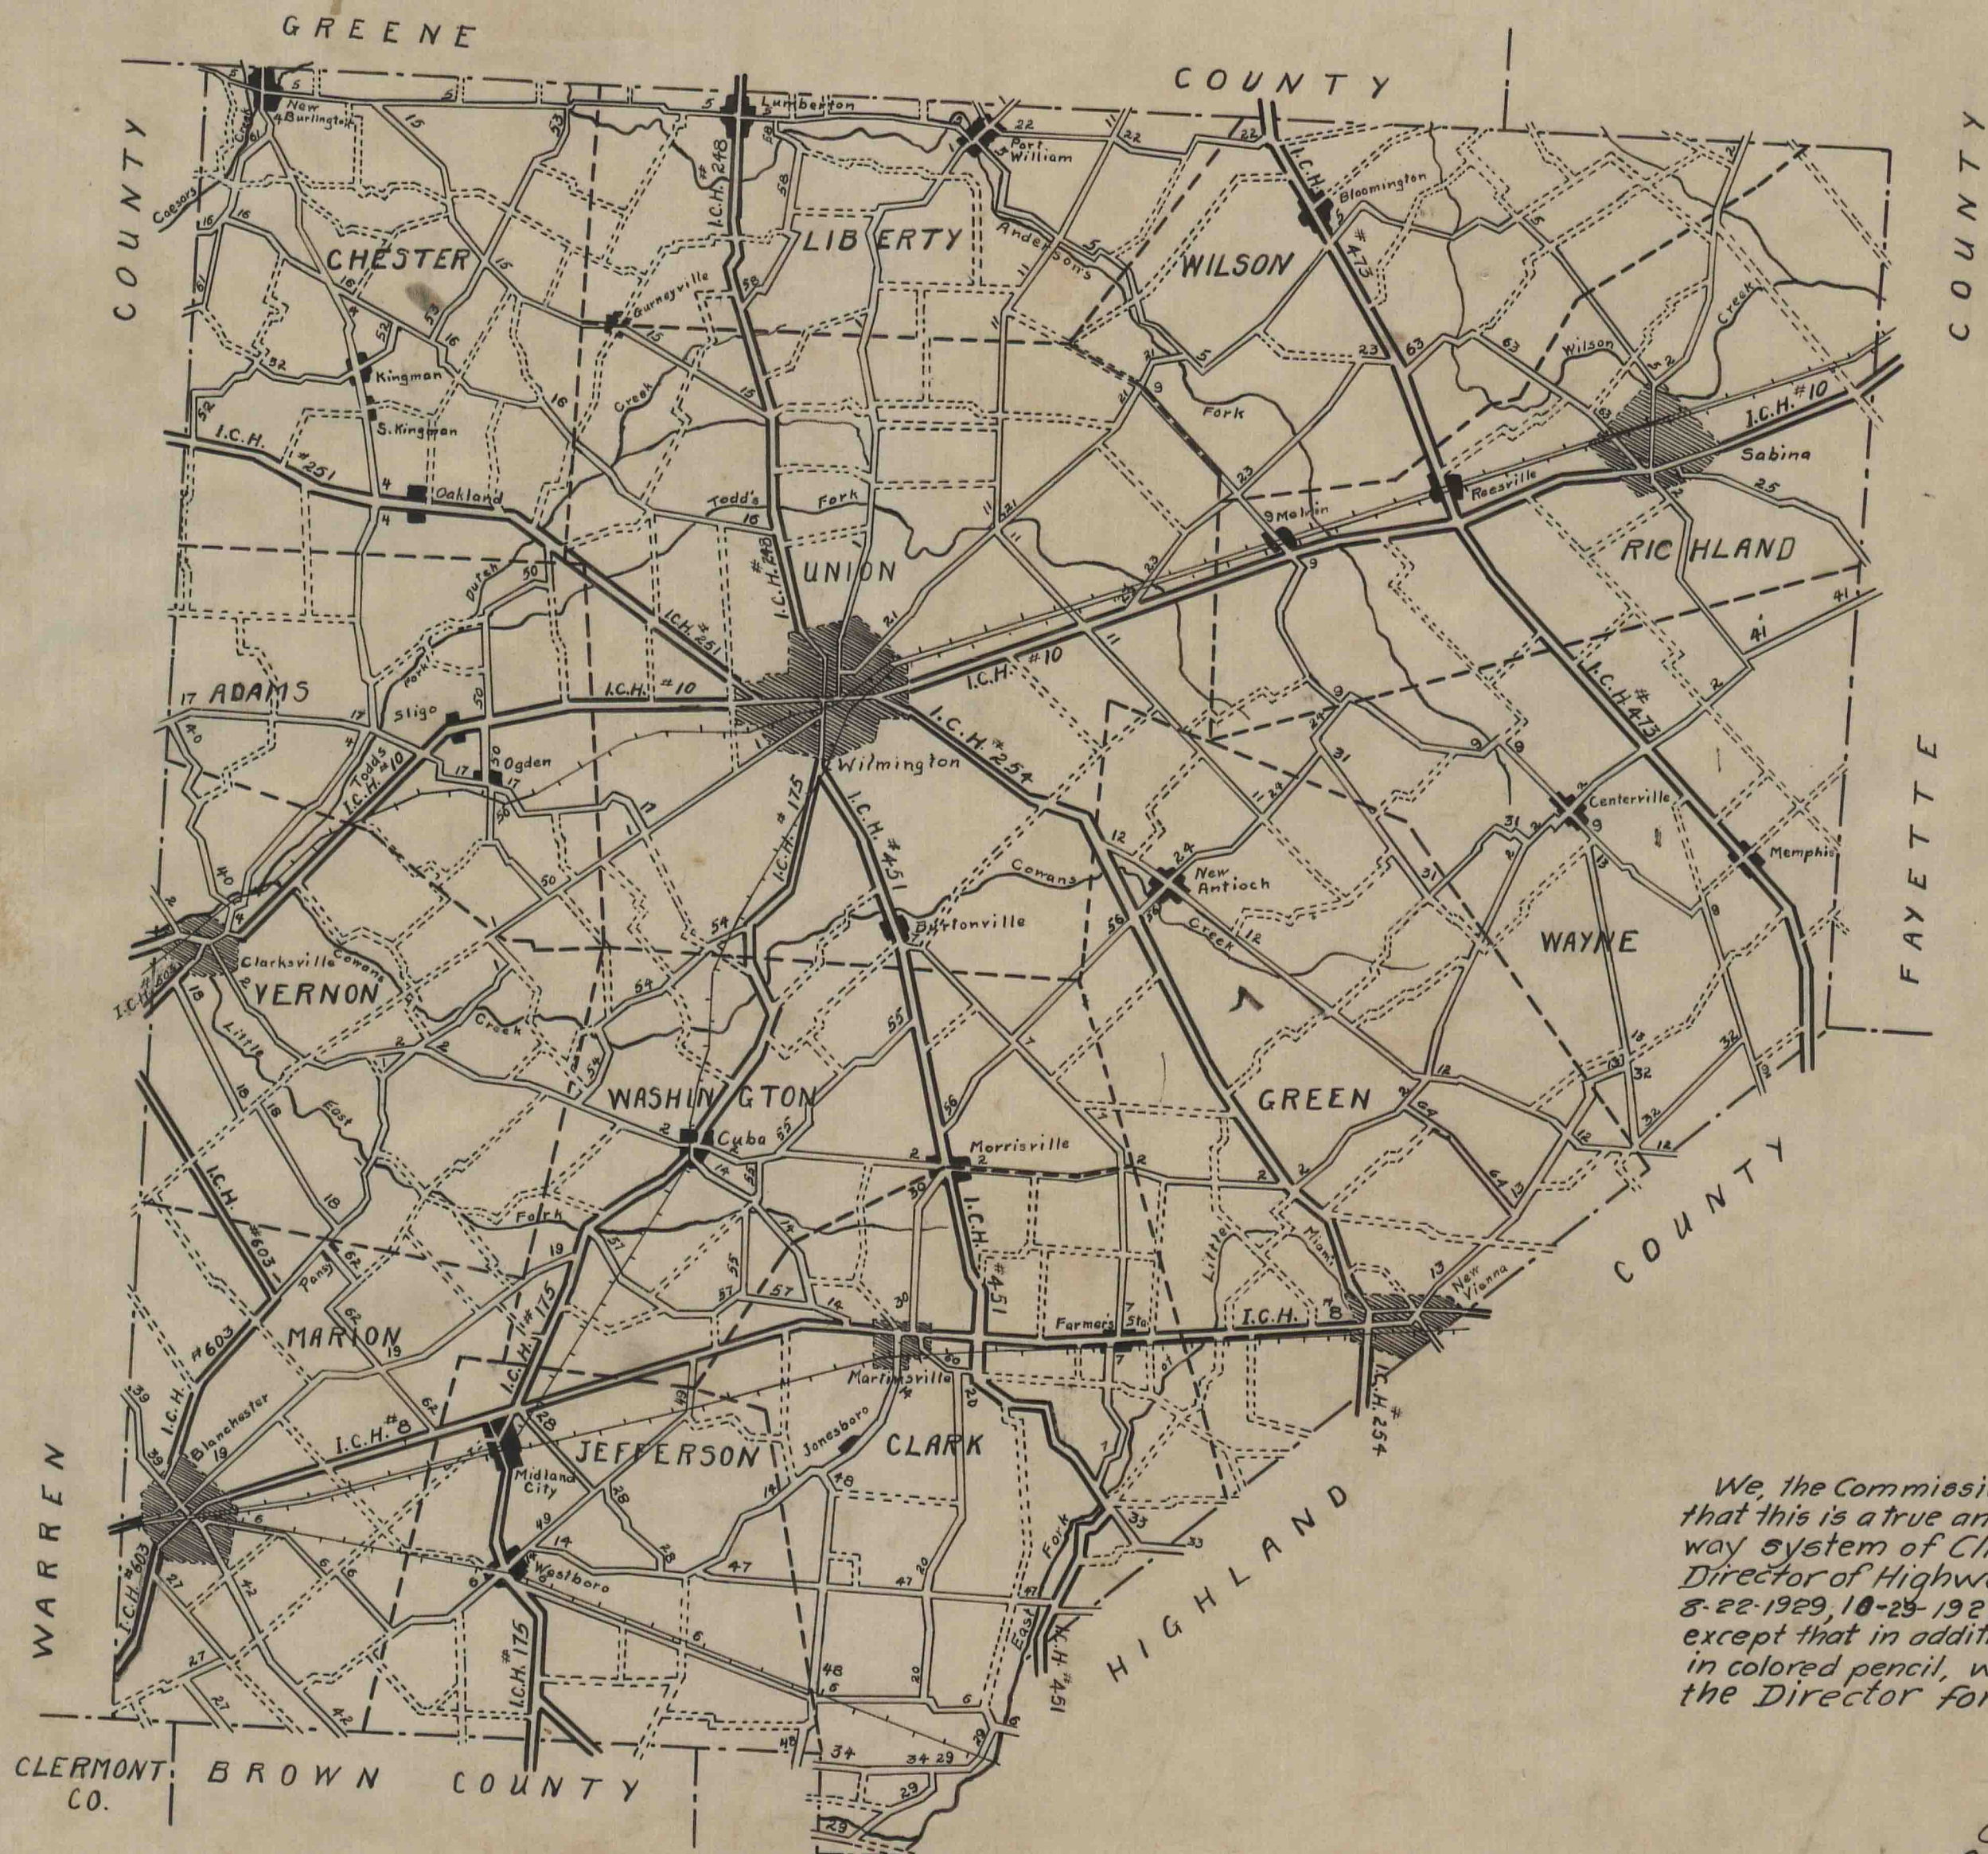

Dec. 27, 1932  
We, the Commissioners of Clinton County, hereby certify that this is a true and correct copy of the County Highway system of Clinton Co. as approved by the Director of Highways and Public Works on 6-22-1926, 8-22-1929, 10-25-1929, 8-19-1930, 7-13-1931 and 9-2-1932, except that in addition it also shows revisions, outlined in colored pencil, which we do hereby submit to the Director for approval. (G.C. 6966).

H.A. Donohoo  
D. Le Couplin  
Frank Richardson  
County Commissioners

APPROVED 193  
Director of Highways.

RED LINES DENOTE ADDITIONS  
YELLOW LINES REMOVALS.

LEGEND  
 ——— INTER-COUNTY HIGHWAYS  
 ——— COUNTY HIGHWAYS  
 - - - - - OTHER ROADS

MAP OF  
COUNTY HIGHWAY SYSTEM  
OF  
**CLINTON COUNTY**  
SCALE 1 INCH = 2 MILES

APPROVED G.F. Schlesinger 6/22/26  
DIRECTOR OF HIGHWAYS AND PUBLIC WORKS